Assessor's Record Map

Block 1 Broadmoor

129-02
9/18

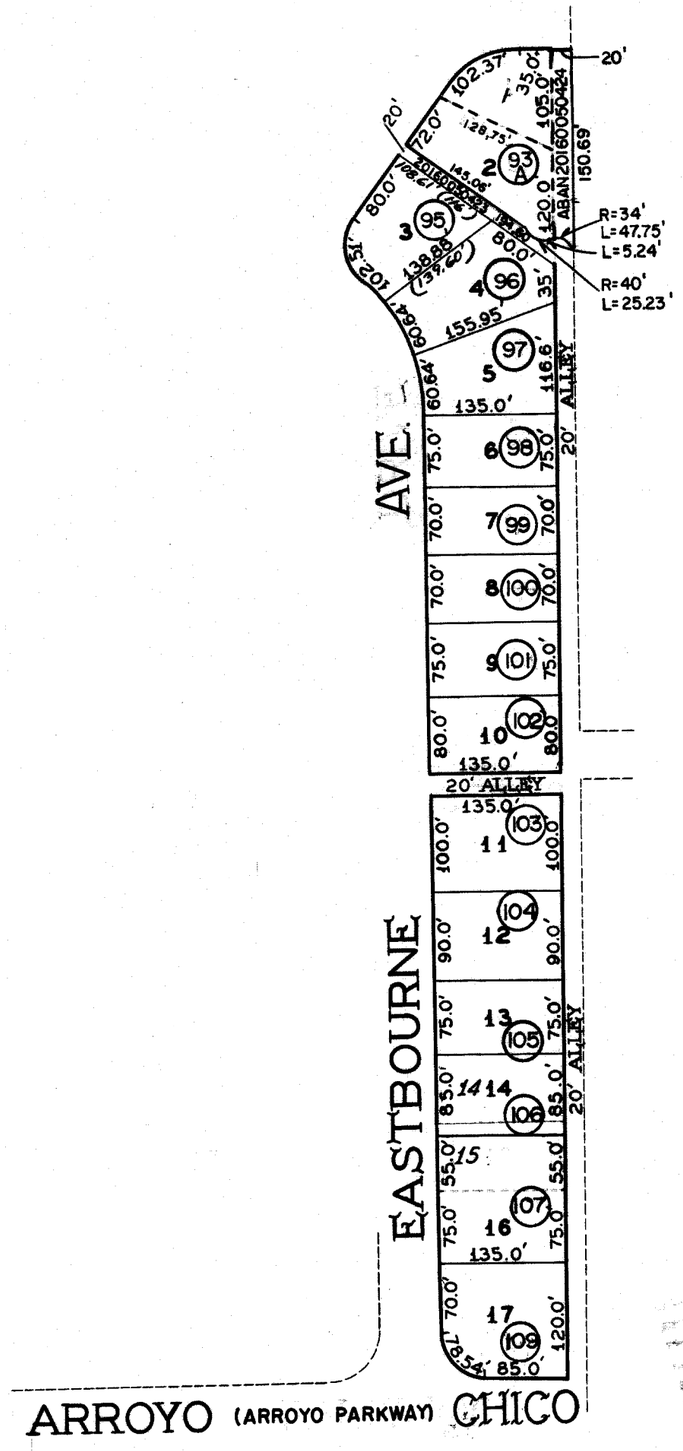

C.O.T. PROJECT

SCALE-1"=150'

SEE BOOK 7, PAGE 46 M & P.

2016-1 ~~X07046XB01~~

SCANNED

M07046_B01 ~~1155(5)~~

"IMPERIAL"—K. & E. CO., N. Y.
REG. U.S. PAT. OFF.